


1. Linear Dimensions

Nominal Length (mm)	Nominal Length (in)	Tolerance (mm)	Tolerance (in)
0.5 – 3	0.020 – 0.118	±0.20	±0.008
>3 – 6	0.118 – 0.236	±0.30	±0.012
>6 – 30	0.236 – 1.181	±0.50	±0.020
>30 – 120	1.181 – 4.724	±0.80	±0.031
>120 – 400	4.724 – 15.748	±1.20	±0.047

2. Angular Dimensions

Shorter Side Length (mm)	Shorter Side Length (in)	Coarse (c) Tolerance
≤10	≤0.394	±1°30' (±1.5°)
>10 – 50	0.394 – 1.969	±1°
>50 – 120	1.969 – 4.724	±0°30' (±0.5°)

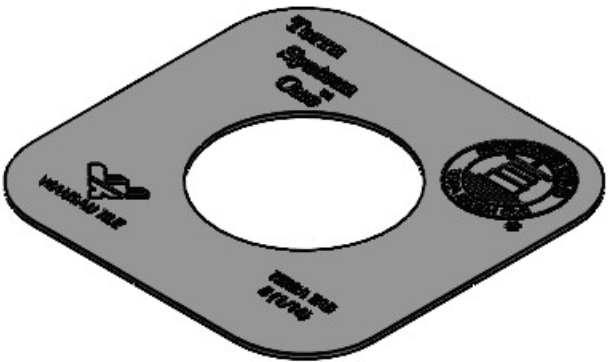

WAUSAU TILE

P.O. BOX 1520, WAUSAU, WI 54402-1520
800-388-8728
E-MAIL: WTILE@WAUSAUTILE.COM
WEBSITE: WWW.WAUSAUTILE.COM

REVISIONS

	NAME	DATE	NOTES
1	MWJ	6/15/11	REDRAWN
2	JEM	10/28/15	REDRAW IN SW
3			
4			
5			
6			
7			
8			

CONFIDENTIAL INFORMATION
THESE DRAWINGS, SPECIFICATIONS AND OTHER INFORMATION AND DOCUMENTS ACCOMPANYING THEM ARE THE CONFIDENTIAL AND PROPRIETARY PROPERTY OF WAUSAU TILE, INC. THE DRAWINGS THEMSELVES SHALL BELONG TO THE OWNER FOR USE ONLY ON THE PROJECT. ANY ADDITIONAL USE SHALL REQUIRE THE PRIOR WRITTEN APPROVAL OF WAUSAU TILE, INC. THE PROPRIETARY INFORMATION CONTAINED WITHIN THE DRAWINGS AND THE DOCUMENTS IS AND SHALL REMAIN THE SOLE PROPERTY OF WAUSAU TILE, INC.

TERRA SHIM #5 (1/16" THICK)

UNLESS OTHERWISE SPECIFIED
DIMENSIONS ARE IN INCHES
TOLERANCE:
FRACTIONS ± 1/8" ANGLE ±0.5°
DIM: 2-PL ±0.01 3-PL ±.005

DRAWN BY: GRM 12/23/1986

DATE: 10/20/2025

MATERIAL:





CO NUMBER:

WEIGHT:

NUMBER: 10010 - REV.1

3. External Radii and Chamfers

Nominal Radius / Chamfer (mm)	Nominal Radius / Chamfer (in)	Tolerance (mm)	Tolerance (in)
0.5 – 3	0.020 – 0.118	±0.20	±0.008
>3 – 6	0.118 – 0.236	±0.50	±0.020
>6 – 30	0.236 – 1.181	±1.00	±0.039
>30	>1.181	±2.00	±0.079

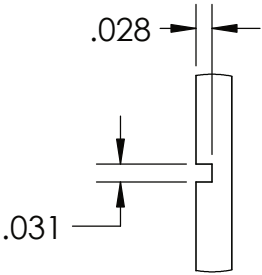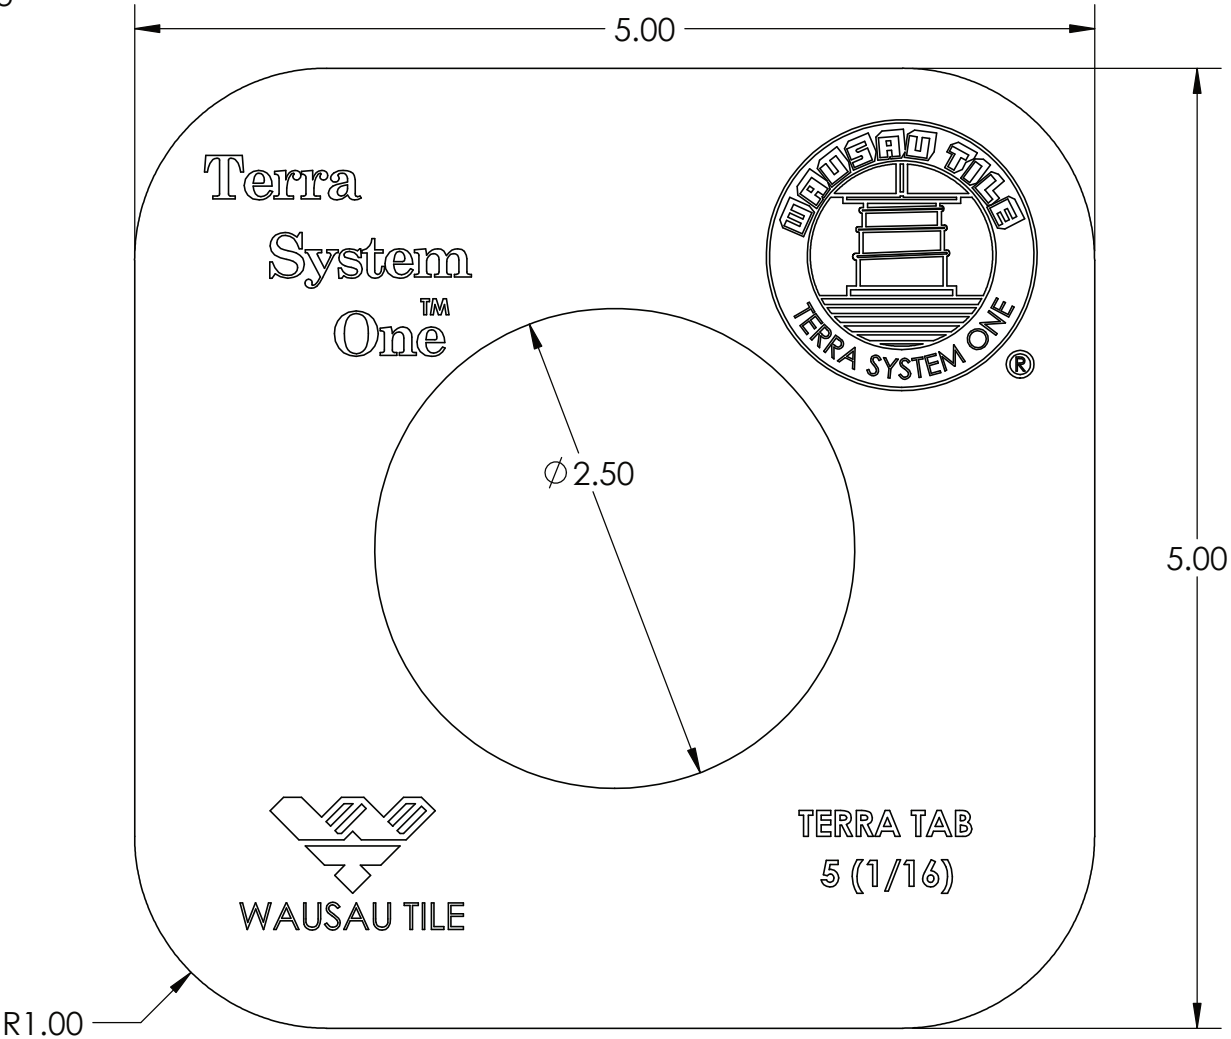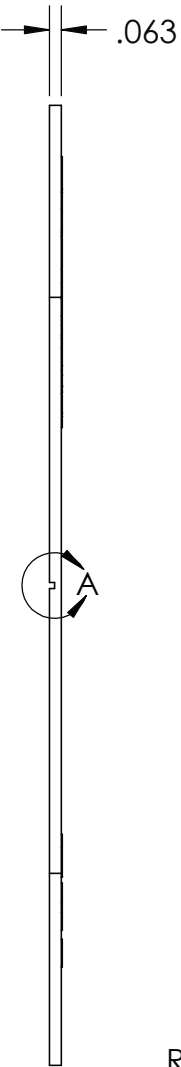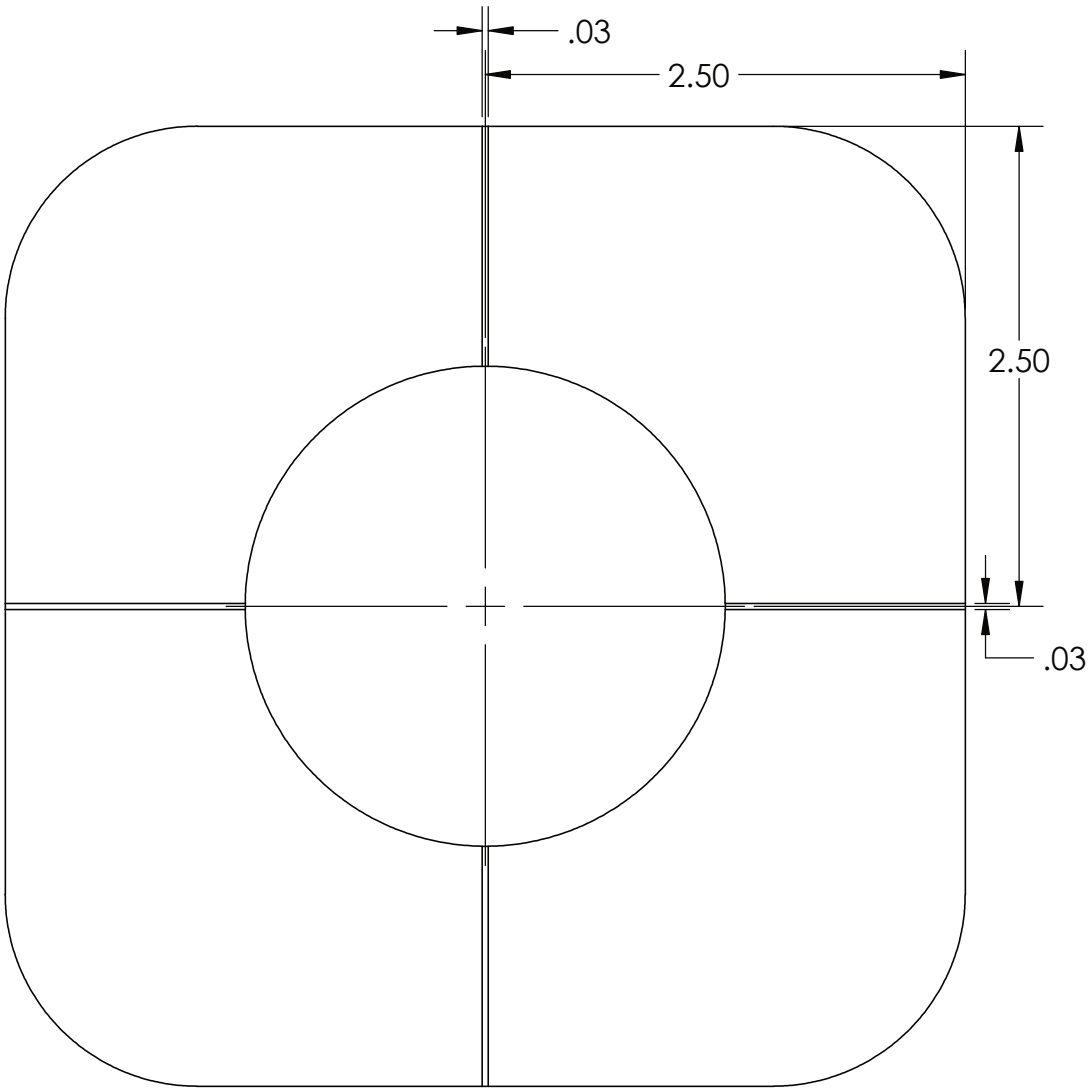

DETAIL A
SCALE 3 : 1

NOTES:

- PRE-FORMED WEIGHT 57 GRAMS
- FINISHED WEIGHT 26 GRAMS
- MATERIAL: SBR RUBBER
- 70 DUROMETER